DEVELOPER: DALE KRAKER
NEEDS POLE RELOCATED DUE TO
GRADE CHANGE IN DECEL LANE

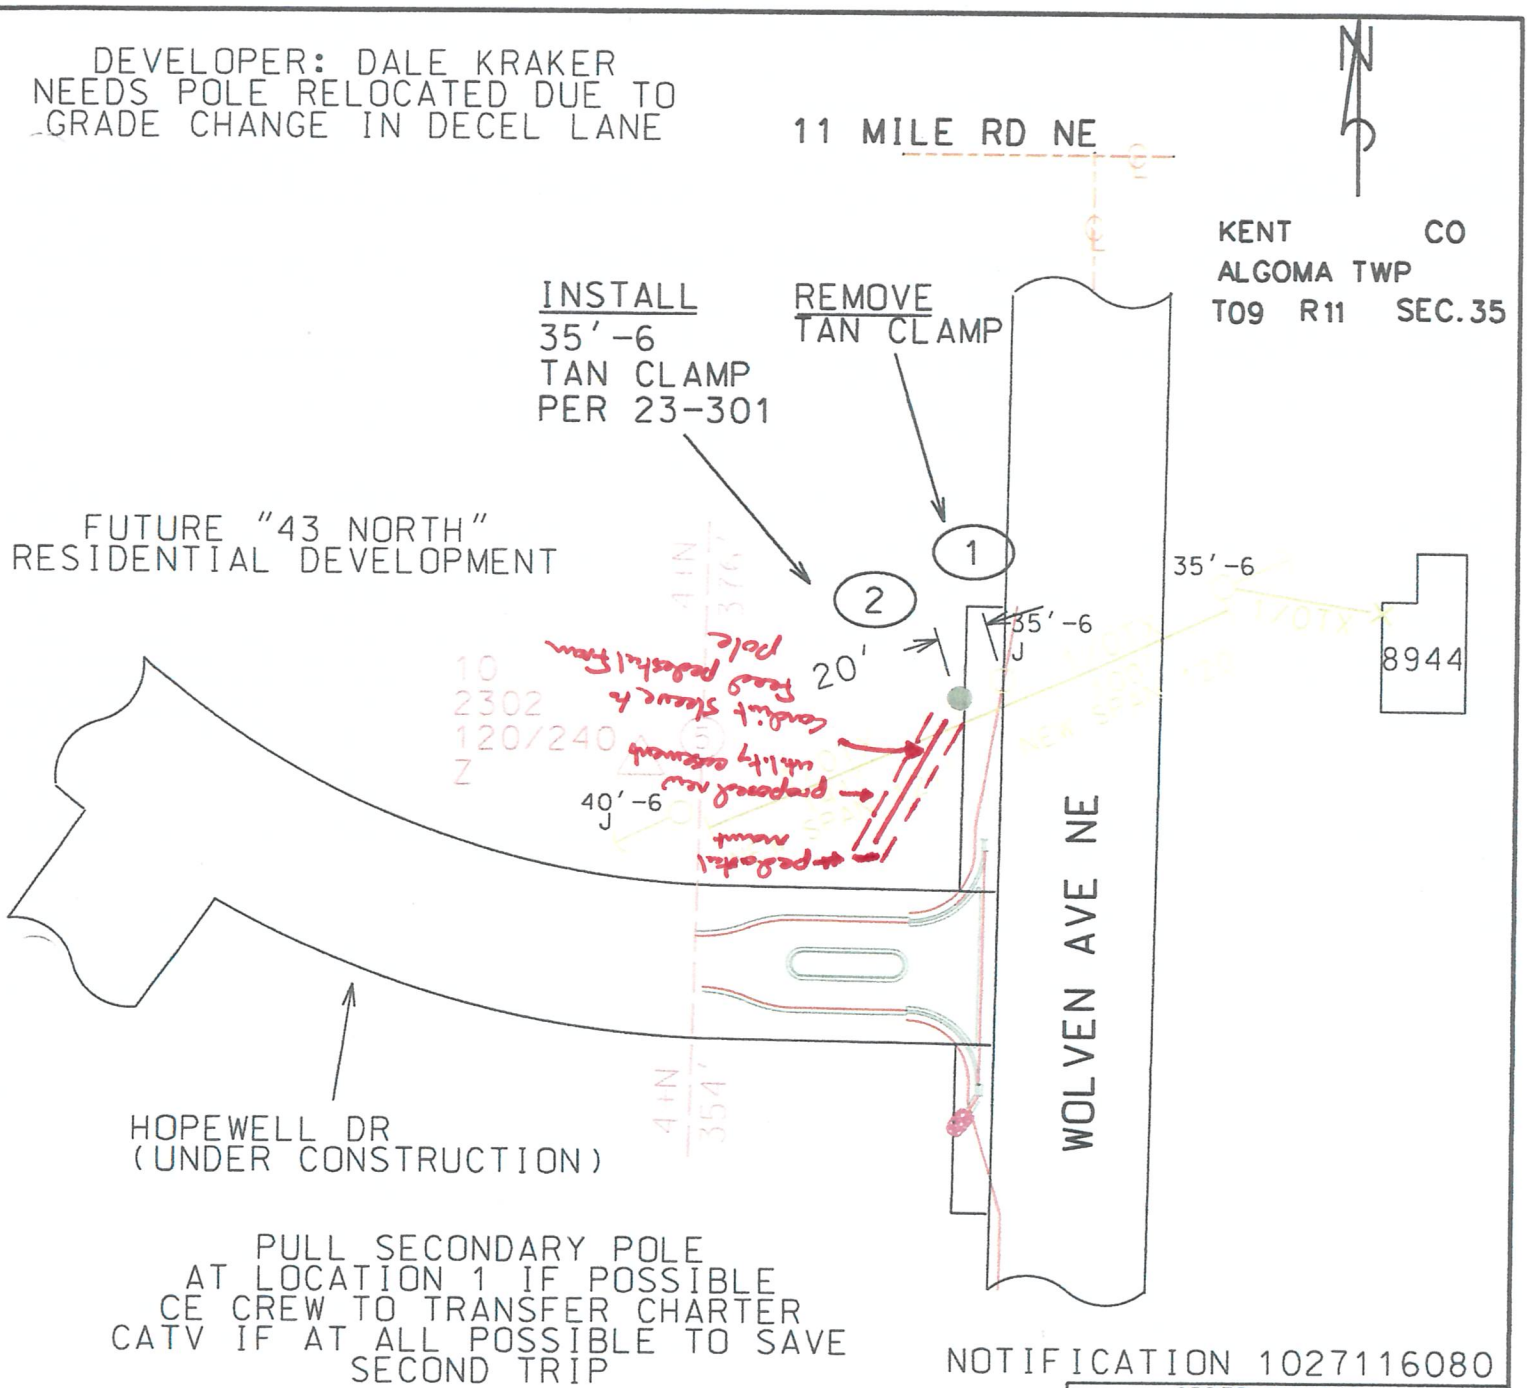

PULL SECONDARY POLE
AT LOCATION 1 IF POSSIBLE
CE CREW TO TRANSFER CHARTER
CATV IF AT ALL POSSIBLE TO SAVE
SECOND TRIP

NOTIFICATION 1027116080

ORDER NUMBER

Consumers Energy
A CMS Energy Company ELECTRIC

DESIGNED BY	DATE	43 NORTH DEV RLOC SEC POLE RKFD
JMONEILL	08/27/14	
APPROVED BY	DATE	For: WOLVEN INVESTMENTS LLC 43 NORTH NLU DEV POLE RLC RKFD
SHEET 1 OF 1	SCALE 1"=90'	

-CONSTRUCTION CERTIFICATION-

Work was constructed as Engineered or Changed as Indicated.
All Salvageable Material Was Returned to Stores.

Signed _____ in Direct Charge of Work

Do Started _____ Completed _____

MISS DIG NUMBER: _____ DATE: _____

TLM NUMBER	# OF RODS	OHMS	CONSTRUCTION MEASURE NUMBER		
0911352302			100003109698		
			ORDER TYPE	MAINTENANCE ACTIVITY TYPE	DESIGN NUMBER
SUBSTATION	WD NO.		ECNC	RLO	10520389
ROGUE RIVER	1042				
CIRCUIT	CKT NO.	LCP NO.	STAKED	[x] YES	[ ] NO
CANNON FARMS	01	0520	TREES	[ ] YES	[x] NO

ELECTRIC CAD TITLE BLOCK (8-1/2x11) 10-30-2008
SHEET A

DESIGN FILE NAME: 10520389.001
T R S 09 11 35